

August 4, 2017

Via Electronic Filing

Chief Clerk
NC Utilities Commission

RE: Docket No. SP-4345, Sub 0
ABD Farm Solar, LLC
Notice of Additional Access Road

Dear Clerk Jarvis,

Reference is made to that certain Application for a Certificate of Public Convenience and Necessity filed in the above-listed docket on June 23, 2014 (the “**CPCN Application**”). Reference is also made to that certain Application to Register a New Renewable Energy Facility filed in the above-listed docket on June 16, 2014 (the “**Application to Register**”).


Enclosed for filing is an updated site plan (the “**Updated Site Plan**”) of the facility (the “**Facility**”) owned by ABD Farm Solar, LLC. The only change to the original site plan that was submitted with the CPCN Application and the Application to Register is an additional access road (the “**Additional Access**”) that will be used during construction of the Facility. Please note that a portion of the Additional Access runs along Sunflower Drive, which is a pre-existing road that will be widened for construction of the Facility. The Additional Access is shown in red on the Updated Site Plan.

Thank you for your assistance with this matter. If you should require additional information and/or have any questions, please feel free to contact us directly at regulatory@ccrenew.com.

[Signature Page Follows]

Thank you,

ABD FARM SOLAR, LLC

By: 
Name: Jerome O'Brien
Title: Authorized Person


State of California
County of Los Angeles

A notary public or other officer completing this certificate verifies only the identity of the individual who signed the document to which this certificate is attached, and not the truthfulness, accuracy, or validity of that document.


On August 3, 2017 before me, Michelle Kamins Notary Public personally appeared Jerome O'Brien who proved to me on the basis of satisfactory evidence to be the person(s) whose name(s) is/are subscribed to the within instrument and acknowledged to me that he/she/they executed the same in his/her/their authorized capacity(ies), and that by his/her/their signature(s) on the instrument the person(s), or the entity upon behalf of which the person(s) acted, executed the instrument.


I certify under PENALTY OF PERJURY under the laws of the State of California that the foregoing paragraph is true and correct.

WITNESS my hand and official seal.

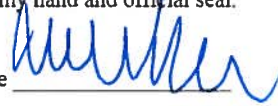Signature 

Signature of Notary Public

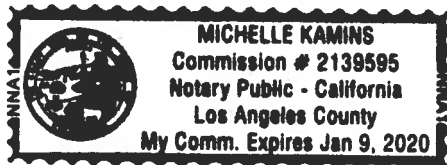

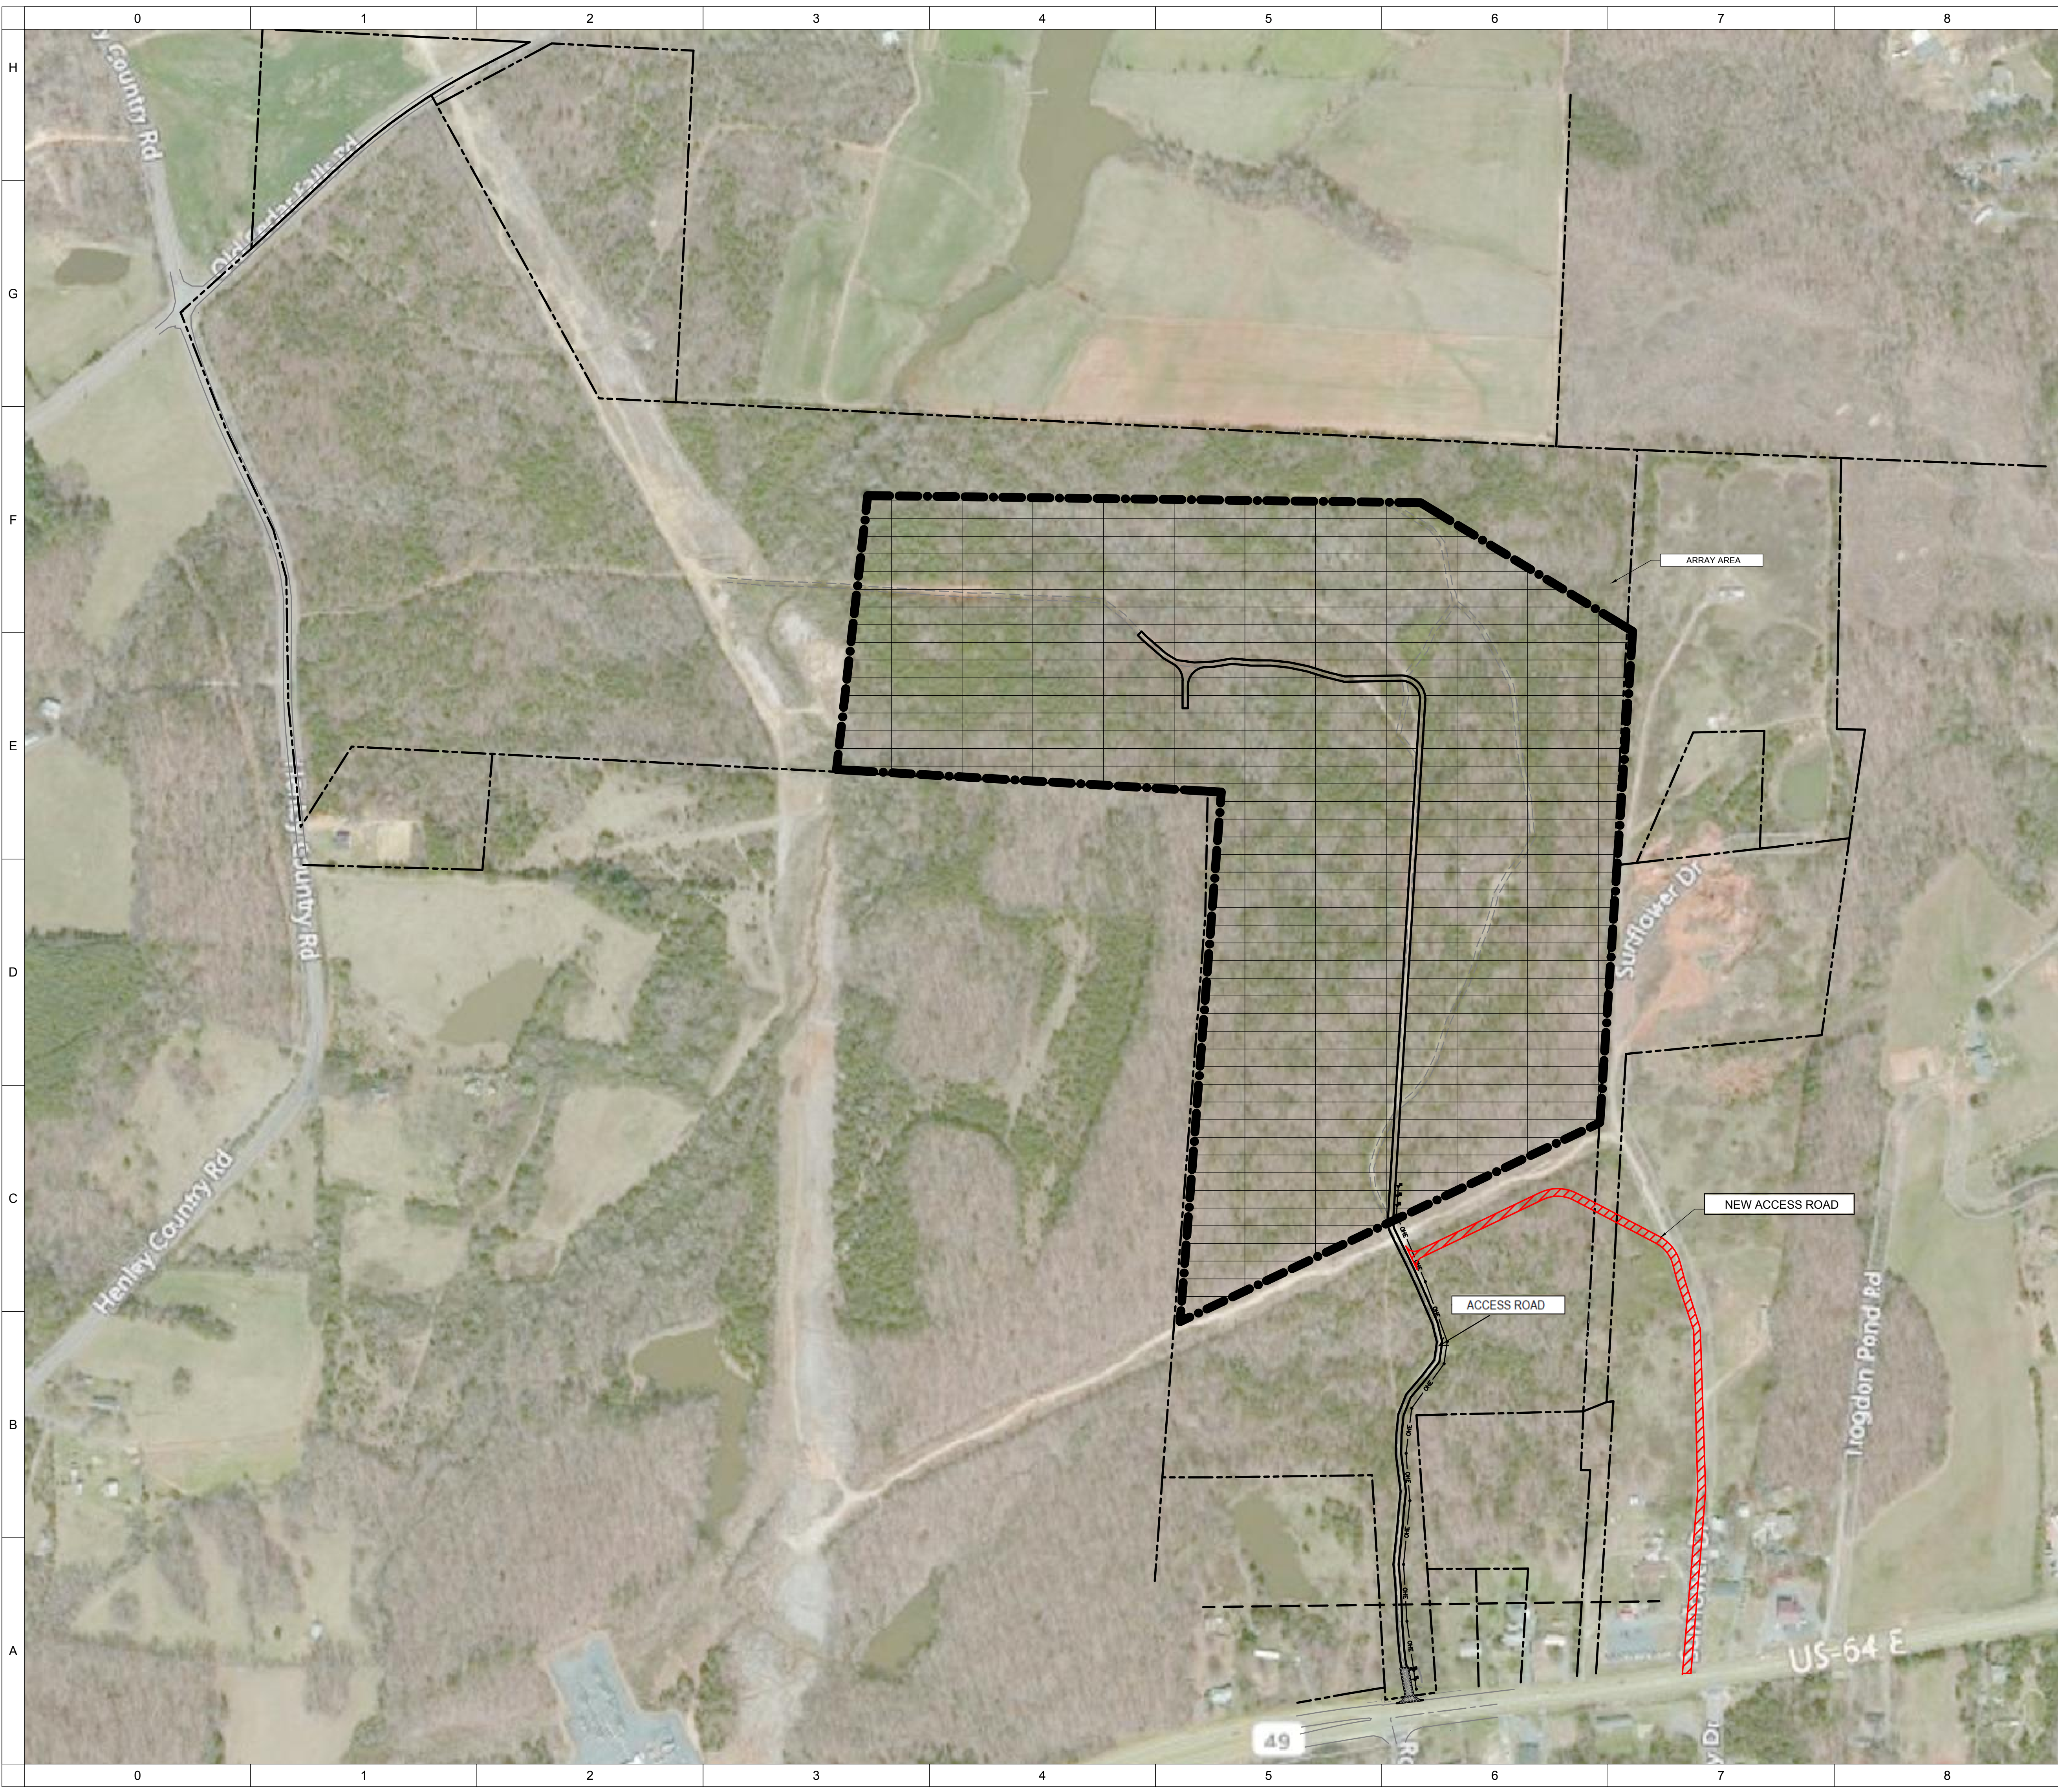

VICINITY MAP

SCALE 1" = 5000'

GENERAL NOTES

1. THE LOCATION OF PROPOSED EQUIPMENT INCLUDING BUT NOT LIMITED TO: FENCING, SOLAR ARRAY RACKING, ELECTRICAL EQUIPMENT, OVERHEAD POLES AND LINES, ETC., SHOWN ARE APPROXIMATE AND MAY BE SUBJECT TO MODIFICATION DUE TO SITE CONDITIONS, ADDITIONAL PERMITTING REQUIREMENTS, EQUIPMENT SPECIFICATIONS AND/OR OTHER CONSTRAINTS.

2. PROPERTY BOUNDARIES, TOPOGRAPHIC DATA, AND EXISTING IMPROVEMENTS SHOWN ARE APPROXIMATE PER AERIAL PHOTOGRAPHY AND GIS MAPS.

3. THIS PLAN IS PRELIMINARY AND WILL NOT BE RELEASED FOR CONSTRUCTION.

PROJECT INFO

STREET ADDRESS:

COUNTY:

3205 US HWY 64 E

ASHEBORO, NC 27203

RANDOLPH

SEAL

PRELIMINARY

NOT FOR

CONSTRUCTION

CONSULTANT

REVISIONS

REV	DATE	DESCRIPTION

PROJECT

LEGEND

PROJECT AREA BOUNDARY

SOLAR ARRAY AREA

NEW ACCESS ROAD

GRAPHIC SCALE

1" = 200'

NORTH

N

DATE:

08-01-17

DRAWN BY:

AR

CHECKED BY:

MEC

CPCN SITE PLAN

P0.1

ABD FARM SOLAR, LLC

3705 NC HWY 64 E

ASHEBORO, RANDOLPH COUNTY, NC

3250 OCEAN PARK BLVD., SUITE 305 :: SANTA MONICA, CA 90406

Aug 04 2017

OFFICIAL COPY